Rodney
DISTRICT COUNCIL
PRIVATE BAG 500, OREWA
PH. 0-9-426 5169

Owner: K. McCLEAN

Consent No: 992037

Job Address: REMUERA RD PUHOI

Inspector: MURRAY Cook

Lot No: 1

D.P. No: 175712

Inspected Date: 15/9/99
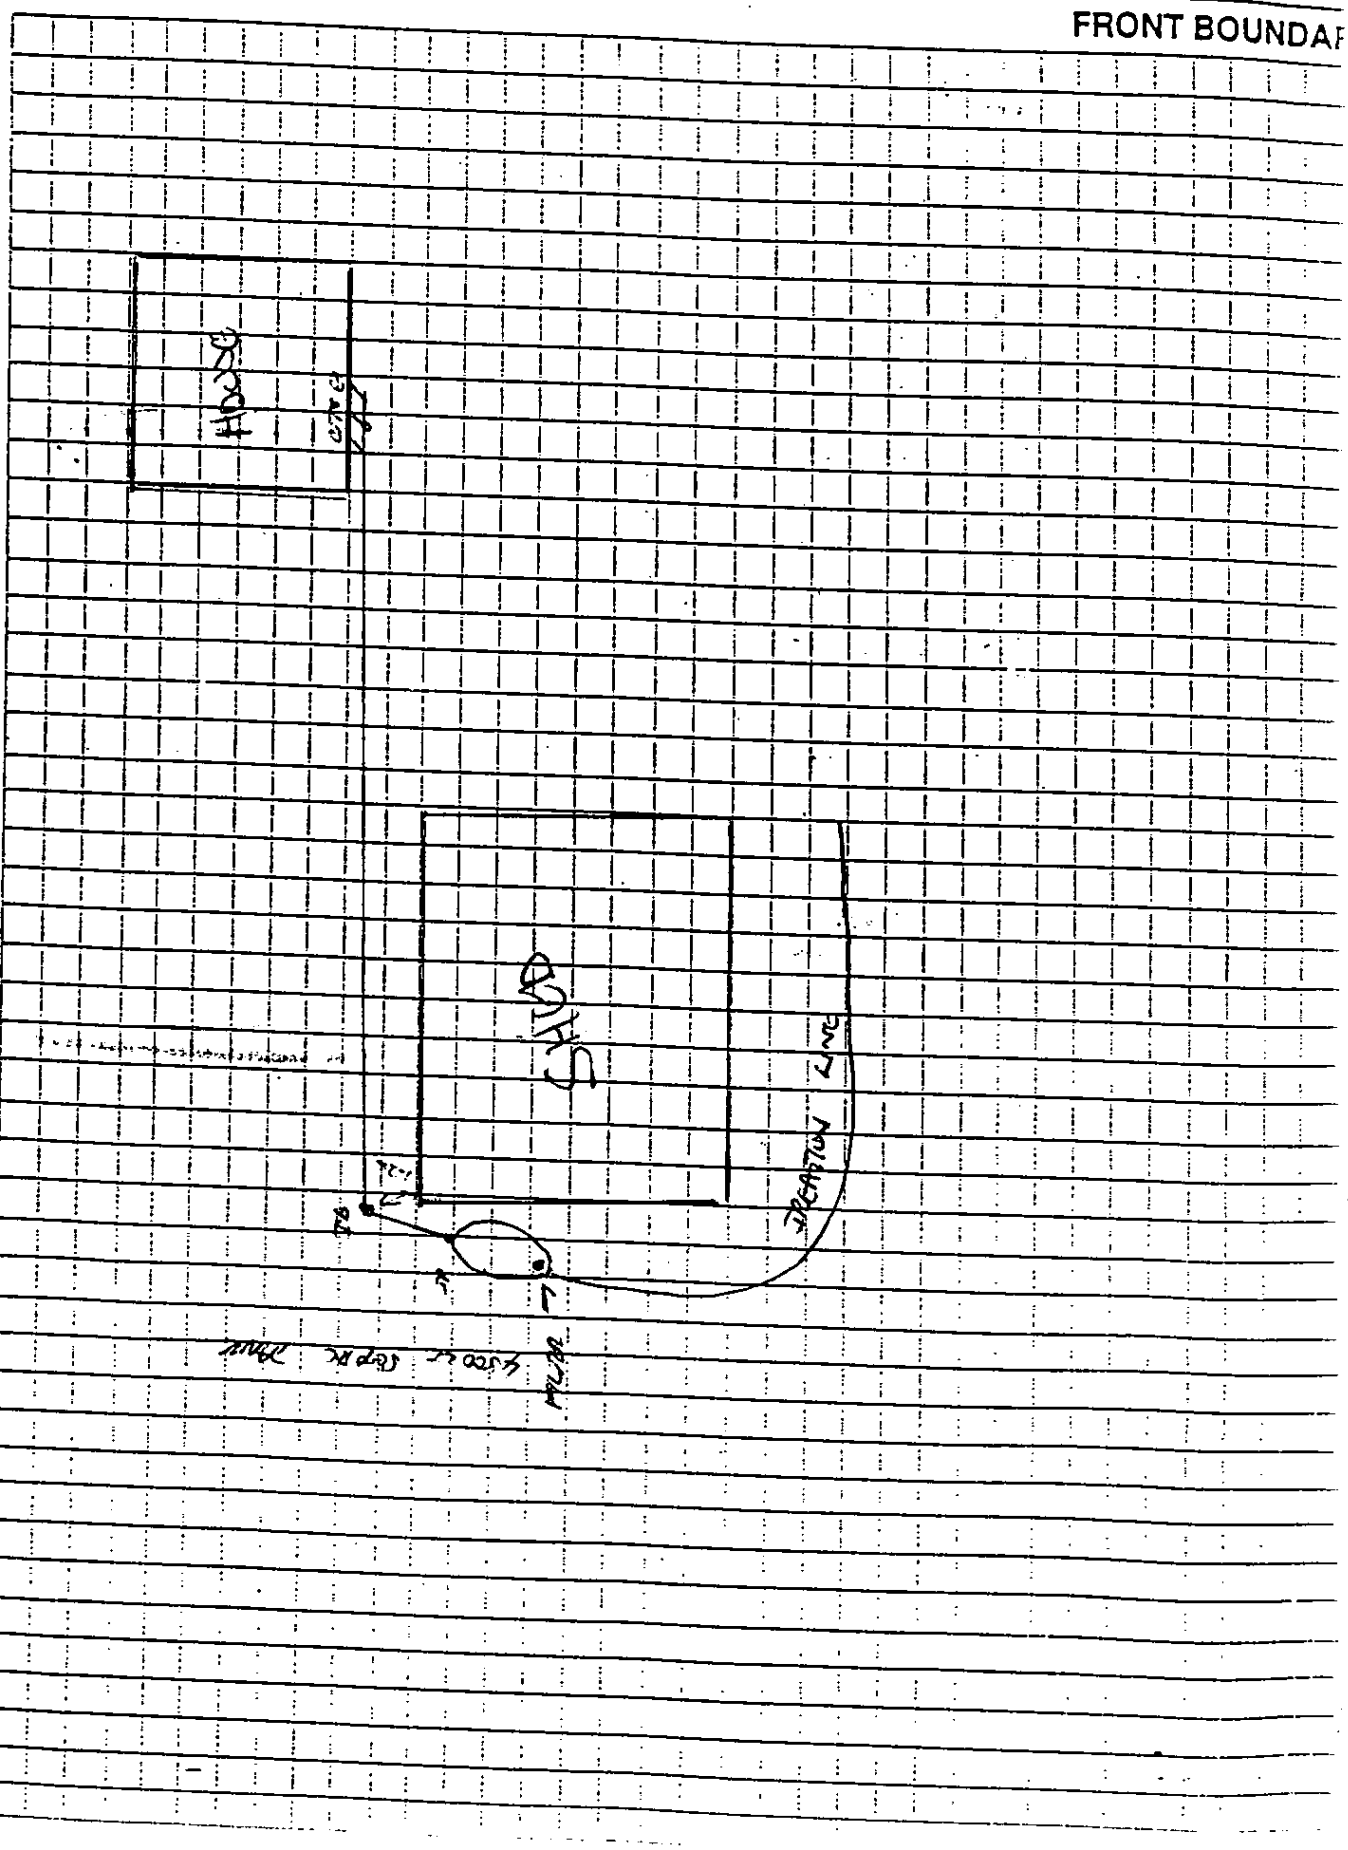
DRAINLAYERS - NAME & ADDRESS M STANNARD RD1 KKVI